

June 10, 2026

ADDENDUM NO. 2 – RFB-463
Parking Garage Elevator Replacement at
Fairmont State University
Fairmont, WV



DOCUMENTS AMENDED

In accordance with AIA Document A701 Instructions to Bidders, Article 1, 1.1, the drawings and specifications for **Parking Garage Replacement at Fairmont State University**, as prepared by Tower Engineering and Williamson Shriver Architects, Inc., are hereby amended, and all changes (in either addition or deduction) which may result due to the following amendments shall be included in the bid.

GENERAL INFORMATION:

1. The last day for questions is **June 9, 2026**, at 2:00 p.m., with the last addendum being issued on June 10, 2026, if necessary.
2. Contact the Facilities Department (304-367-4110) for site visits at Fairmont State University.

QUESTION & ANSWERS:

1. Is there a specification or a basis of design for the new sump pump?
Answer: Refer to the attached sheet H101r for more information.
2. Are there any additional details for the plumbing of the new sump pump?
Answer: Refer to the attached sheet H101r for more information.
3. Under alternate #1 the ground floor door is being removed for the new elevator, is there any work with this door under the base bid?
Answer: No work for Alternate No. 1 is included in the base bid scope. The contractor may be required to locate new work within the footprint of the elevator due to the location.
4. Is there any painting of the CMU outside the elevator doors? Is there a specification for the painting of the pit ladder?
Answer: No painting of existing CMU will be required at the elevator doors.
Answer: Paint shall be exterior-grade paint to withstand the moisture level located in the elevator pit.
5. Holeless dual telescoping cylinders cannot achieve the 66ft of travel (max out ~50ft). To achieve 66ft, need to go to roped hydraulic or traction elevator. Please advise.
Answer: Traction Elevator is acceptable to achieve the required height.
6. Would a modernization of the two existing elevators be acceptable in lieu of total replacement?
Answer: No.
7. Would a traction elevator (MRL) be acceptable for the alternate #1?
Answer: Yes, comply with elevator requirements to achieve the required height.
8. Is the existing shaft designed for surface mounted fasteners to support new components?
Answer: The existing shaft was designed to receive mounts compliant with existing elevator design requirements.

9. Are there any details or cuts of the existing shafts?

Answer: Not at this time.

10. Are there any details or ratings for the existing hoist beam?

Answer: Not at this time.

11. If we are to bid a holeless elevator, are we to extract the existing buried shaft and piston?

Answer: Traction Elevator is acceptable.

12. What material are we to backfill the shaft hole with?

Answer: Lean fill concrete.

13. Is the new elevator car to have glass on the backwall? Nothing stating in the documents. Please clarify and provide details/sizing if needed.

Answer: Yes, new elevator to match the appearance of the existing elevator with a glass back wall.

14. Is the rear wall of the elevator cab to be glass?

Answer: Yes.

15. Before we proceed further, could you please confirm whether the existing hydraulic piston(s) will be replaced as part of this project, or if the intent is to retain the current piston(s)?

Answer: The intent is to replace the current piston(s).

16. Due to the travel height of the elevator, sourcing a direct replacement piston of the required length may be challenging and could significantly impact cost and lead time. If replacement is required, an alternative solution may be a twin-post hydraulic configuration; however, this option would involve additional equipment, installation configuration, and associated costs.

Answer: Stay with the current design of piston replacement.

17. Please advise if we are to reuse existing sump pump discharge piping to new sump pump. If we are to replace pump discharge piping, please provide information to where we are to route piping on drawings as well as what the piping application is to be for work.

Answer: Refer to revised H-101r included in this addendum.

18. Please advise if the controls for split system are to be stand alone controls or if they are to be tied into an existing bas system. If they are to be tied into bas system please provide a bod.

Answer: Refer to revised H-101r included in this addendum.

BIDDING REQUIREMENTS:

1. None

CLARIFICATION:

1. None.

SPECIFICATIONS:

1. None.

DRAWINGS:

1. Drawing E-001
 - a. Replace sheet E-001 with E-001r included in this addendum.


2. Drawing E-101
 - a. Replace sheet E-101 with E-101r included in this addendum.

3. Drawing H-101
 - a. Replace sheet H-101 with H-101r included in this addendum.


END OF ADDENDUM

HVAC SYMBOLS & ABBREVIATIONS

PIPING SYMBOLS


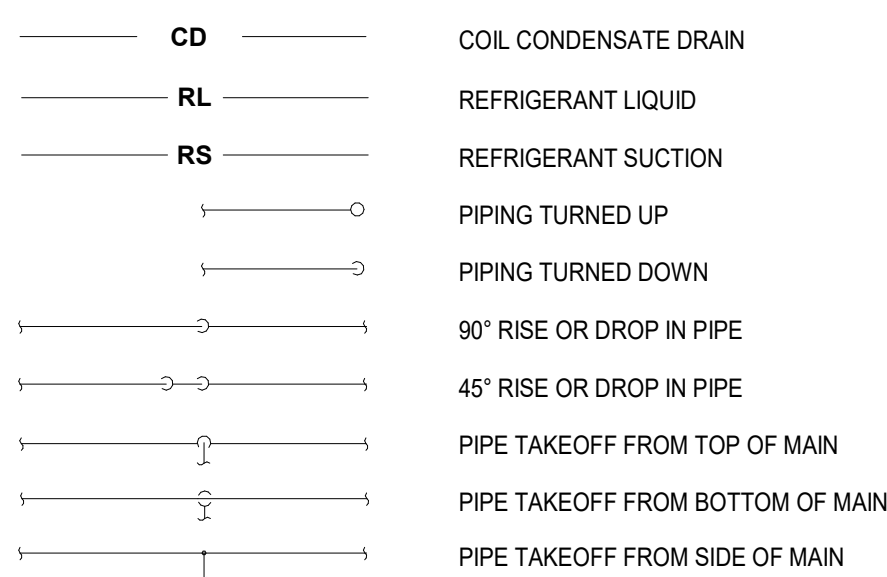


GENERAL DRAWING SYMBOLS

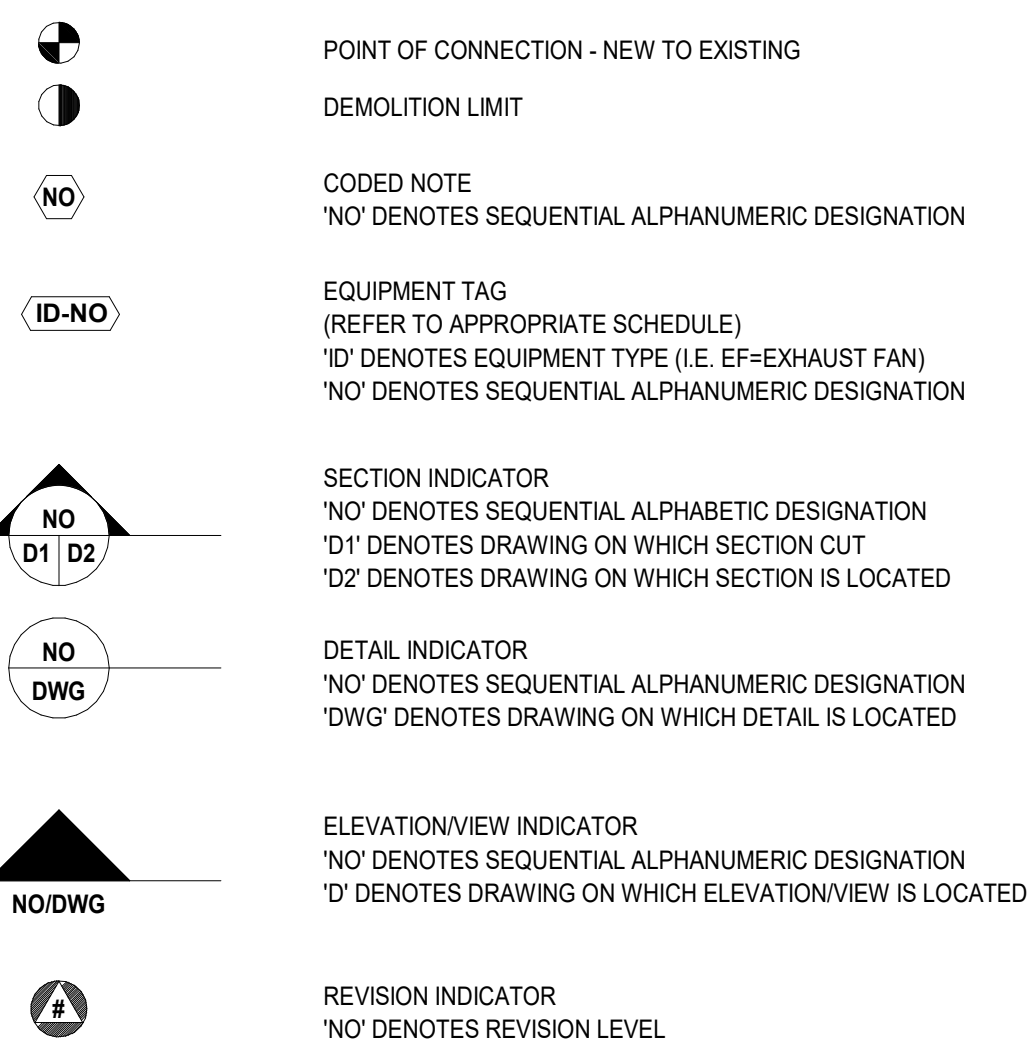


ABBREVIATIONS

ALT	ALTERNATE	FURN	FURNISH
ASHRAE	AMERICAN SOCIETY OF HEATING, REFRIGERATING AND AIR-CONDITIONING ENGINEERS	GC	GENERAL CONTRACTOR
ASME	AMERICAN SOCIETY OF MECHANICAL ENGINEERS	HVAC	HEATING, VENTILATING & AIR CONDITIONING
ASTM	AMERICAN SOCIETY FOR TESTING AND MATERIALS	IN	INCH
ATC	AUTOMATIC TEMPERATURE CONTROL	LBS	POUNDS
BAS	BUILDING AUTOMATION SYSTEM	MANUF.	MANUFACTURER
BLDG	BUILDING	MBH	1000 BTUH
BTUH	BRITISH THERMAL UNITS/HOUR	MCA	MINIMUM CIRCUIT AMPS
CD	COIL CONDENSATE DRAIN	MIN	MINIMUM
CFM	CUBIC FEET PER MINUTE	MOCP	MAXIMUM OVER CURRENT PROTECTION
CO	CLEAN OUT	MTD	MOUNTED
CONN	CONNECTION	NO.	NUMBER
CP	CONTROL PANEL	PH	PHASE
CU	CONDENSING UNIT	REFRIG.	REFRIGERANT
'F	DEGREE FAHRENHEIT	RS	REFRIGERANT SUCTION
DEMO	DEMOLITION	SFC	SPLIT FAN COIL UNIT
DX	DIRECT EXPANSION	T	THERMOSTAT
FLA	FULL LOAD AMPS	TEMP	TEMPERATURE
FT	FEET	TYP	TYPICAL
		V	VOLTAGE

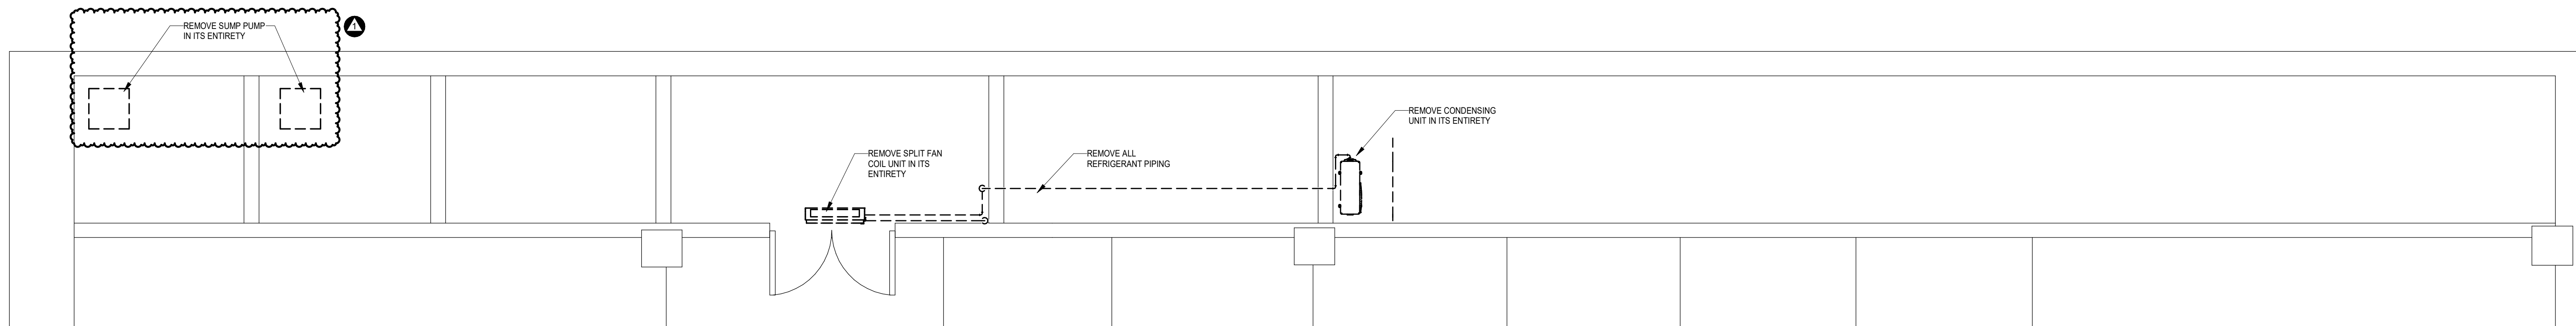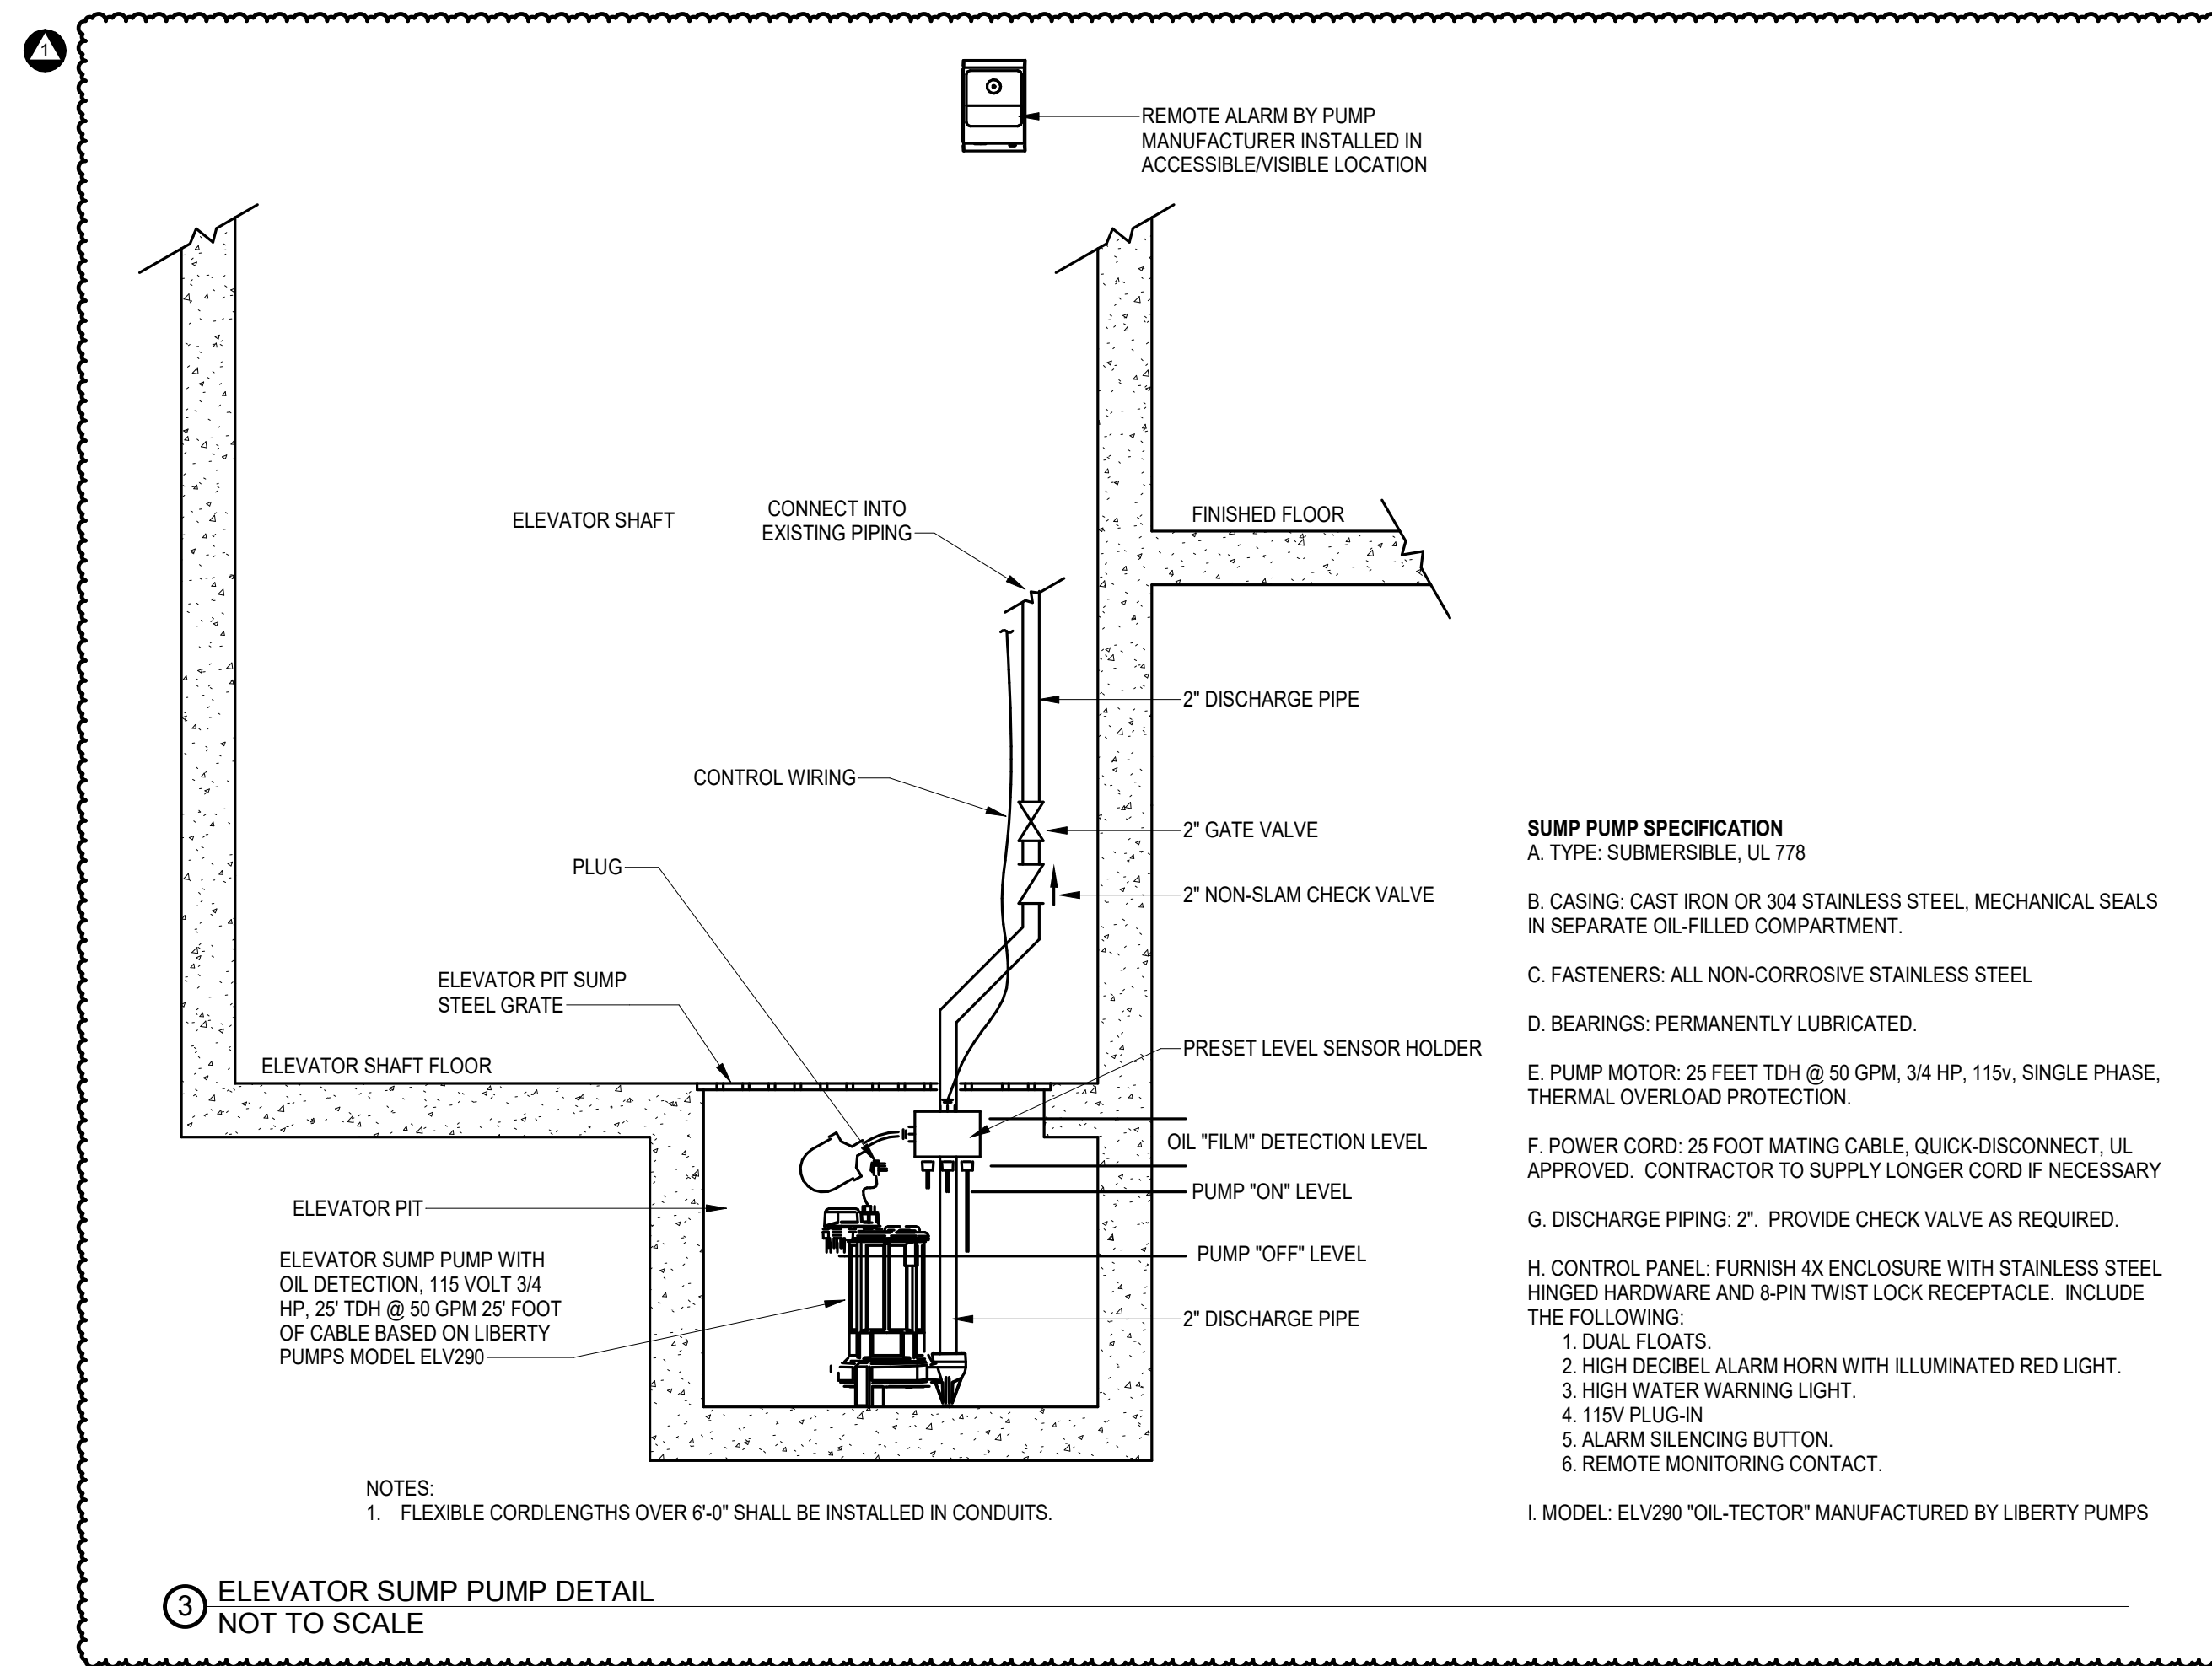

1 FIRST FLOOR HVAC DEMOLITION
1/4" = 1'-0"

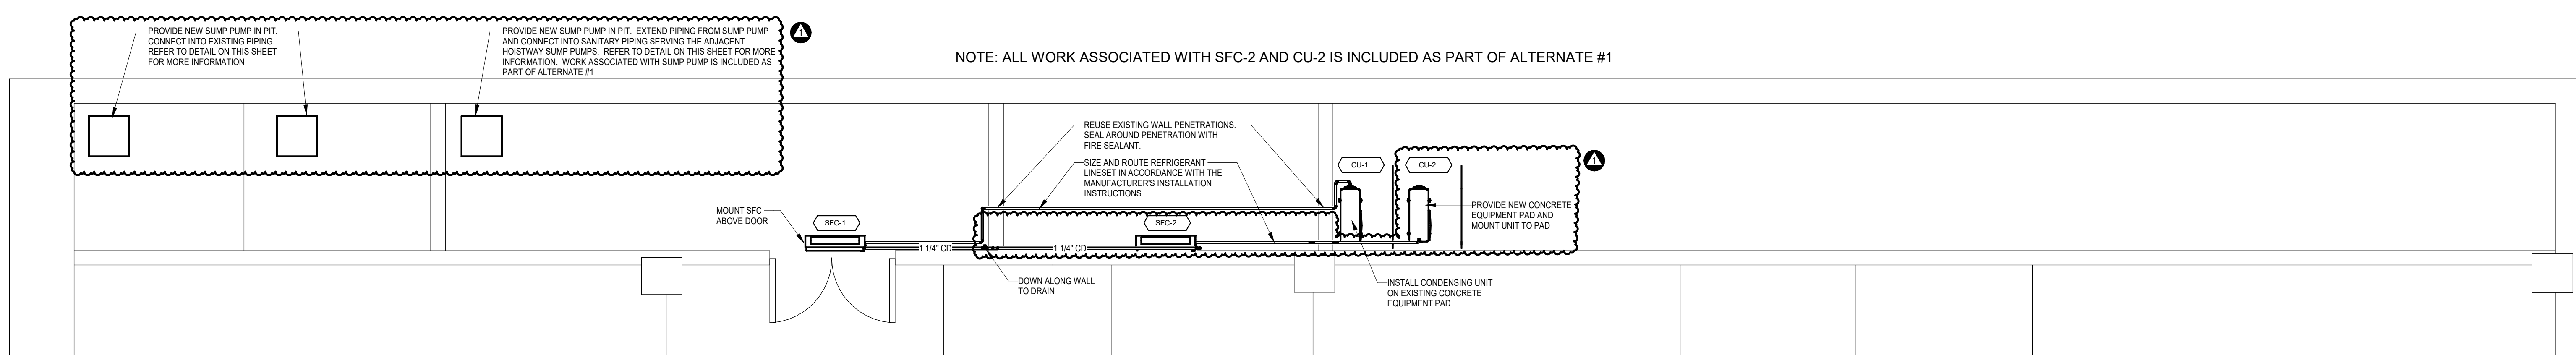

2 FIRST FLOOR HVAC NEW
1/4" = 1'-0"

SPLIT FAN COIL UNIT SCHEDULE (DX COOLING WITH REMOTE CONDENSING UNIT)																
UNIT NO.	AREA SERVED	TOTAL COOLING (MBH)	TOTAL HEATING (MBH)	FAN COIL DATA				REMOTE CONDENSING UNIT DATA						REMARKS		
				V	PH	MANUF.	MODEL	UNIT NO.	UNIT FLA	UNIT MCA	UNIT MOCP	V	PH		MANUF.	MODEL
SFC-1	ELEVATOR EQUIPMENT ROOM	15	19.4	208	1	DAIKIN	MSZ-FS15NA	CU-1	81	18	20	208	1	DAIKIN	MUZ-FS15NAH	1-4
SFC-2	ELEVATOR EQUIPMENT ROOM	15	19.4	208	1	MITSUBISHI	MSZ-FS15NA	CU-2	81	18	20	208	1	MITSUBISHI	MUZ-FS15NAH	1-4

REMARKS
1. INTEGRAL CONDENSATE PUMP
2. INTEGRAL DISCONNECT ON FAN COIL
3. AUTOMATIC RESTART AFTER POWER FAILURE
4. WALL MOUNTED UNIT

TOWER ENGINEERING
115 Evergreen Heights Drive, Suite 400, Pittsburgh, Pennsylvania 15229
Phone: (412) 931-8888 Fax: (412) 939-2525
Project Number: 2025004

PARKING GARAGE ELEVATOR REPLACEMENT AT FAIRMONT STATE UNIVERSITY

Fairmont State University
Fairmont, WV 26554

No.	Description
1	ADDENDUM #2

HVAC PLANS

Date: 05/27/26
Drawn By: RCH

H101r